


SOURCE: GOUSHA/CHEC-CHART-UNITED STATES, CANADA, MEXICO ROAD ATLAS

SITE LOCATION MAP

SHEET NO.	DRAWING NO.	SHEET TITLE
1 OF 16	FLOO18-CWP-D01	TITLE SHEET
2 OF 16	FLOO18-CWP-D02	EXISTING SITE CONDITIONS
3 OF 16	FLOO18-CWP-D03	REGRADED WASTE PLAN
4 OF 16	FLOO18-CWP-D04	INTERMEDIATE GRADE PLAN
5 OF 16	FLOO18-CWP-D05	FINAL GRADE AND SITE PLAN
6 OF 16	FLOO18-CWP-D06	CROSS SECTIONS EXISTING AND REGRADED WASTE
7 OF 16	FLOO18-CWP-D07	CROSS SECTIONS INTERMEDIATE GRADE
8 OF 16	FLOO18-CWP-D08	CROSS SECTIONS FINAL COVER
9 OF 16	FLOO18-CWP-D09	PLAN & PROFILE LEACHATE COLLECTION SYSTEM MODIFICATIONS
10 OF 16	FLOO18-CWP-D10	LEACHATE TRANSFER PAD DETAILS
11 OF 16	FLOO18-CWP-D11	STORMWATER TRENCH MODIFICATIONS
12 OF 16	FLOO18-CWP-D12	CAP DRAIN DETAILS
13 OF 16	FLOO18-CWP-D13	GAS VENTING SYSTEM DETAILS
14 OF 16	FLOO18-CWP-D14	PERIMETER DITCH PROFILE
15 OF 16	FLOO18-CWP-D15	MISCELLANEOUS DETAILS
16 OF 16	FLOO18-CWP-D16	MISCELLANEOUS DETAILS

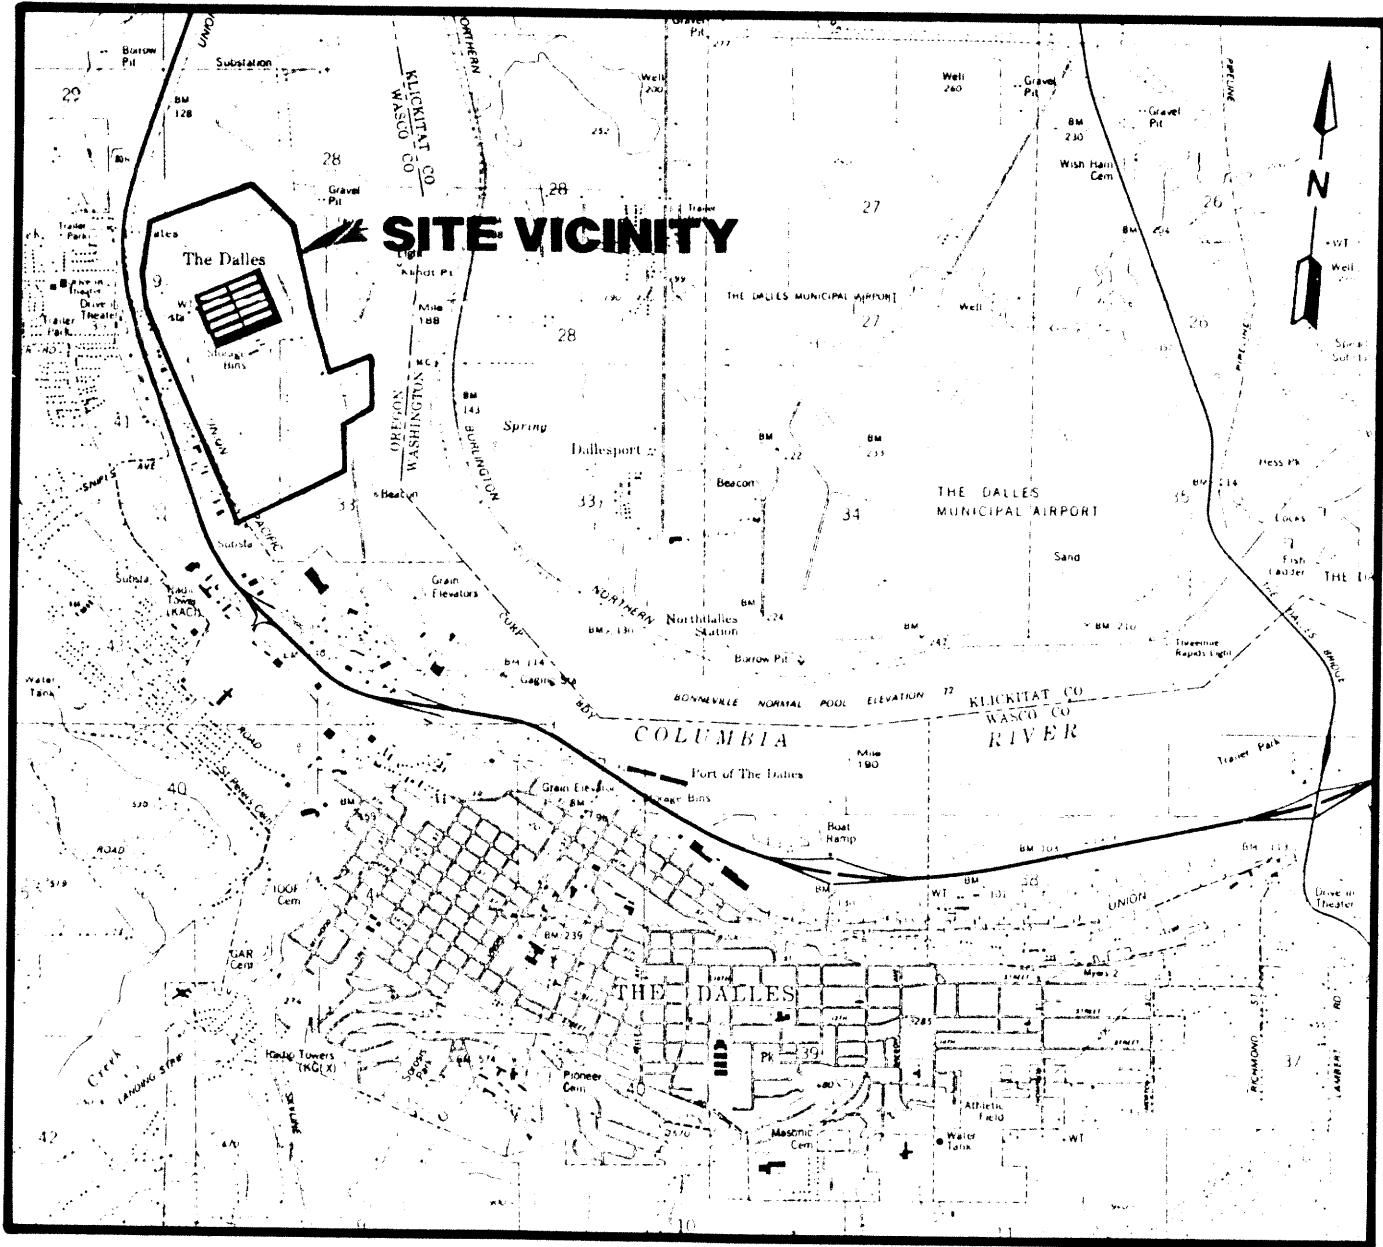

SOURCE: UNITED STATES DEPARTMENT OF THE INTERIOR GEOLOGICAL SURVEY, 1977

SITE VICINITY MAP

RECORD DRAWINGS

RCRA LANDFILL CLOSURE

MARTIN MARIETTA CORPORATION

THE DALLES, OREGON

RECORD DRAWING NOTES:

1. ALL ITEMS IDENTIFIED AS "PROPOSED" ON THESE RECORD DRAWINGS WERE INSTALLED, UNLESS OTHERWISE NOTED.
2. ALL ITEMS DESCRIBED AS "NOT TO BE DISTURBED" WERE NOT DISTURBED, UNLESS OTHERWISE NOTED.
3. ALL ITEMS CROSSED OUT OR MARKED OMIT, WERE NOT UTILIZED IN THE EXECUTION OF THIS CONSTRUCTION WORK.

RECORD DRAWING

SHEET 1 OF 16

DRAWING CONFIDENTIAL: THIS DRAWING AND ALL INFORMATION CONTAINED THEREON IS AND SHALL REMAIN THE PROPERTY OF G&M CONSULTING ENGINEERS, INC. AS AN INSTRUMENT OF PROFESSIONAL SERVICE. THIS INFORMATION SHALL NOT BE USED, IN WHOLE OR IN PART, WITHOUT THE FULL KNOWLEDGE AND PRIOR WRITTEN CONSENT OF G&M CONSULTING ENGINEERS.

SCALE VERIFICATION
THIS BAR REPRESENTS
ONE INCH ON THE
ORIGINAL DRAWING:
0
USE TO VERIFY FIGURE
SCALE

REV. NO.	DATE	DESCRIPTION	BY	APPR.
1	9-24-91	REVISED PER REC. DRAW.	A.A.A.	J.G.

DRAWING NO: FLOO18-CWP-D01

DRAWN BY: KEN CARROLL DATE: MARCH 16, 1989
CHECKED: C. DUNCAN DATE: MAY 20, 1989
APPROVED: J. PETERSOHN DATE: MAY 20, 1989

GERAGHTY & MILLER
ENGINEERS, INC.

TITLE SHEET
RCRA LANDFILL CLOSURE
MARTIN MARIETTA CORPORATION
THE DALLES, OREGON